

LOAN DOCUMENT

DTIC ACCESSION NUMBER	<div style="border: 1px solid black; width: 100px; height: 100px; margin: 0 auto;"></div> <p>LEVEL</p>	<p>PHOTOGRAPH THIS SHEET</p>	<div style="border: 1px solid black; width: 100px; height: 100px; margin: 0 auto; display: flex; align-items: center; justify-content: center;"> 0 </div> <p>INVENTORY</p>																												
	<p><i>OPERATIONS AND MAINTENANCE MANUAL ...</i></p> <p>DOCUMENT IDENTIFICATION</p> <p><i>-JUL 97</i></p>																														
	<div style="border: 1px solid black; padding: 10px; margin: 0 auto; width: 80%;"> <p>DISTRIBUTION STATEMENT A</p> <p>Approved for Public Release</p> <p>Distribution Unlimited</p> </div>																														
	<p>DISTRIBUTION STATEMENT</p>																														
<table border="1" style="width: 100%; border-collapse: collapse;"> <tr> <td colspan="2" style="padding: 2px;">ACCESSION FOR</td> </tr> <tr> <td style="padding: 2px;">NTIS</td> <td style="padding: 2px;">GRAM <input checked="" type="checkbox"/></td> </tr> <tr> <td style="padding: 2px;">DTIC</td> <td style="padding: 2px;">TRAC <input type="checkbox"/></td> </tr> <tr> <td colspan="2" style="padding: 2px;">UNANNOUNCED</td> </tr> <tr> <td colspan="2" style="padding: 2px;">JUSTIFICATION</td> </tr> <tr><td colspan="2" style="height: 15px;"></td></tr> <tr><td colspan="2" style="height: 15px;"></td></tr> <tr><td colspan="2" style="height: 15px;"></td></tr> <tr><td colspan="2" style="height: 15px;"></td></tr> <tr> <td colspan="2" style="padding: 2px;">BY</td> </tr> <tr> <td colspan="2" style="padding: 2px;">DISTRIBUTION/</td> </tr> <tr> <td colspan="2" style="padding: 2px;">AVAILABILITY CODES</td> </tr> <tr> <td style="padding: 2px;">DISTRIBUTION</td> <td style="padding: 2px;">AVAILABILITY AND/OR SPECIAL</td> </tr> <tr> <td style="height: 80px; vertical-align: bottom; text-align: center; font-size: 24px;">A-1</td> <td></td> </tr> </table>				ACCESSION FOR		NTIS	GRAM <input checked="" type="checkbox"/>	DTIC	TRAC <input type="checkbox"/>	UNANNOUNCED		JUSTIFICATION										BY		DISTRIBUTION/		AVAILABILITY CODES		DISTRIBUTION	AVAILABILITY AND/OR SPECIAL	A-1	
ACCESSION FOR																															
NTIS	GRAM <input checked="" type="checkbox"/>																														
DTIC	TRAC <input type="checkbox"/>																														
UNANNOUNCED																															
JUSTIFICATION																															
BY																															
DISTRIBUTION/																															
AVAILABILITY CODES																															
DISTRIBUTION	AVAILABILITY AND/OR SPECIAL																														
A-1																															
<p>DISTRIBUTION STAMP</p>		<p>DATE ACCESSIONED</p>	H A N D L E W I T H C A R E																												
<p>DATE RECEIVED IN DTIC</p>		<p>DATE RETURNED</p>																													
<div style="border: 1px solid black; padding: 10px; margin: 0 auto; width: 80%;"> <p style="font-size: 36px; font-weight: bold;">20001226 030</p> </div>		<p>REGISTERED OR CERTIFIED NUMBER</p>																													
<p>PHOTOGRAPH THIS SHEET AND RETURN TO DTIC-FDAC</p>																															

✓

**Operations and Maintenance Manual for the
Expanded-Scale Bioventing System at
Building 8200
Fort Carson, Colorado**

Prepared For



**The US Army Environmental Center
Aberdeen Proving Ground, Maryland**

**Fort Carson
Colorado Springs, Colorado**

and



**Air Force Center for Environmental Excellence
Brooks Air Force Base
San Antonio, Texas**

July 1997



PARSONS

PARSONS ENGINEERING SCIENCE, INC.

1700 Broadway, Suite 900 • Denver, Colorado 80290

AGM01-03-0565

DEFENSE TECHNICAL INFORMATION CENTER
REQUEST FOR SCIENTIFIC AND TECHNICAL REPORTS

Title

AFCEE Collection

1. Report Availability (Please check one box)

- ☒ This report is available. Complete sections 2a - 2f.
☐ This report is not available. Complete section 3.

2a. Number of
Copies Forwarded

1 each

2b. Forwarding Date

July/2000

2c. Distribution Statement (Please check ONE box)

DoD Directive 5230.24, "Distribution Statements on Technical Documents," 18 Mar 87, contains seven distribution statements, as described briefly below. Technical documents MUST be assigned a distribution statement.

- ☒ DISTRIBUTION STATEMENT A: Approved for public release. Distribution is unlimited.
- ☐ DISTRIBUTION STATEMENT B: Distribution authorized to U.S. Government Agencies only.
- ☐ DISTRIBUTION STATEMENT C: Distribution authorized to U.S. Government Agencies and their contractors.
- ☐ DISTRIBUTION STATEMENT D: Distribution authorized to U.S. Department of Defense (DoD) and U.S. DoD contractors only.
- ☐ DISTRIBUTION STATEMENT E: Distribution authorized to U.S. Department of Defense (DoD) components only.
- ☐ DISTRIBUTION STATEMENT F: Further dissemination only as directed by the controlling DoD office indicated below or by higher authority.
- ☐ DISTRIBUTION STATEMENT X: Distribution authorized to U.S. Government agencies and private individuals or enterprises eligible to obtain export-controlled technical data in accordance with DoD Directive 5230.25, Withholding of Unclassified Technical Data from Public Disclosure, 6 Nov 84.

2d. Reason For the Above Distribution Statement (in accordance with DoD Directive 5230.24)

2e. Controlling Office

HQ AFCEE

2f. Date of Distribution Statement
Determination

15 Nov 2000

3. This report is NOT forwarded for the following reasons. (Please check appropriate box)

- ☐ It was previously forwarded to DTIC on _____ (date) and the AD number is _____
- ☐ It will be published at a later date. Enter approximate date if known. _____
- ☐ In accordance with the provisions of DoD Directive 3200.12, the requested document is not supplied because: _____

Print or Type Name

Laura Peña

Telephone

210-536-1431

Signature

Laura Peña

(For DTIC Use Only)

AQ Number M01-03-0565

CONTENTS

	<u>Page</u>
SECTION 1 - INTRODUCTION	1-1
SECTION 2 - SYSTEM DESCRIPTION	2-1
2.1 Blower System.....	2-1
2.2 Monitoring and Flow Control Equipment	2-1
2.2.1 Monitoring Gauges	2-1
2.2.2 Flow Control Equipment	2-1
SECTION 3 - SYSTEM MAINTENANCE.....	3-1
3.1 Blower/Motor.....	3-1
3.2 Air Filter	3-1
3.3 Maintenance Schedule.....	3-2
3.4 Major Repairs	3-2
SECTION 4 - SYSTEM MONITORING.....	4-1
4.1 Blower Performance Monitoring.....	4-1
4.1.1 Vacuum	4-1
4.1.2 Temperature	4-1
4.1.3 Pressure.....	4-1
4.2 Monitoring Schedule	4-1
APPENDICES	
APPENDIX A - Record Drawings	
APPENDIX B - Rotary-Vane Blower Information	
APPENDIX C - Data Collection Sheets	

TABLES

	<u>Page</u>
2.1 Initial and Final Air Flow Rates.....	2-2

SECTION 1

INTRODUCTION

This operations and maintenance (O&M) manual has been created as a guide for monitoring and maintaining the performance of the expanded-scale bioventing blower system at Building 8200, Fort Carson, Colorado. Record drawings for the expanded-scale bioventing system, installed at Building 8200 in May 1997 in accordance with the site remedial action plan, are provided in Appendix A of this O&M manual.

At this site, bioventing is the forced injection of fresh air to enhance the supply of oxygen to native bacteria in subsurface soils for *in situ* bioremediation of fuel hydrocarbons. A blower system is used to inject air into the soil, thereby supplying atmospheric air (with approximately 20.8 percent oxygen) to contaminated soils. Once oxygen is provided to the subsurface, indigenous aerobic bacteria biodegrade fuel residuals. Aerobic biodegradation of fuel compounds in soil is much more efficient than anaerobic biodegradation, which occurs in oxygen-depleted soils.

Parsons Engineering Science, Inc. (Parsons ES) has installed an air injection bioventing system consisting of two air injection blowers, 7 vent wells (VWs), 13 soil gas monitoring points (MPs), and associated piping at the site. The regenerative blower at Building 8200, installed in July 1996, was initially used for air injection into VW1 and VW2. During expanded-scale installation, the air injection piping for VW1 and VW2 was rerouted to a new rotary-vane blower system. The rotary-vane blower was started in May 1997, and the injection rates into each VW (VW1, VW2, VW4, VW5, VW6, and VW7) were optimized over a 21-day period to ensure adequate aeration of contaminated soils. The regenerative blower is now used for air injection into the newly constructed horizontal VW (VW3) that is located within the former tank excavation.

Fort Carson Directorate of Environmental Compliance and Management (DECAM) personnel located at Fort Carson are responsible for routine monitoring of the bioventing systems. Parsons ES has trained DECAM personnel on the monitoring requirements of this plan. If significant problems are encountered with the operation of the system, Parsons ES should be notified so repairs can be made. Under the Air Force Center for Environmental Excellence (AFCEE) Extended Bioventing Project Option 1 scope of work, Parsons ES is responsible for system repair for a 1-year period after system startup (i.e., until May 1998). Should the bioventing system cease to operate or develop significant problems, please call the Parsons ES Site Manager, Mr. Dave Teets, at (303) 831-8100.

SECTION 2

SYSTEM DESCRIPTION

2.1 Blower Systems

A Gast® 6066-P122-T339 rotary-vane blower powered by a 5-horsepower, direct-drive motor was installed at Building 8200. The blower is rated for a flow rate of 53 standard cubic feet per minute (scfm) at a pressure of 5 pounds per square inch (psi); however, the actual performance of the blower will vary with changing site conditions. Details of the O&M of the Gast® R5 regenerative blower installed in July 1996 are contained in the *O&M Manual for the Pilot-Scale Bioventing System at Building 8200, Fort Carson, Colorado* (Parsons ES, 1996). Table 2.1 presents the flow rate into each of the injection VWs in actual cubic feet per minute (acfm). The new blower system includes an inlet air filter to remove any particulate matter which may be entrained in the inlet air stream, a secondary air filter, and several valves and monitoring gauges, which are described in Section 2.2. An as-built schematic of the expanded-scale blower system installed at Building 8200 is shown in Appendix A. Corresponding blower performance curves and relevant service information are provided in Appendix B.

2.2 Monitoring and Flow Control Equipment

2.2.1 Monitoring Gauges and Ports

The rotary-vane blower system is equipped with one vacuum gauge, one pressure gauge, and one temperature gauge. The vacuum gauge is located on the inlet piping between the air filter and the blower, and the temperature and pressure gauges are located on the outlet piping. Each individual VW manifold pipe has one air velocity measurement port (i.e., each VW has its own individual flow measurement port). Refer to the record drawings in Appendix A for exact gauge and port locations.

2.2.2 Flow Control Equipment

Manual and automatic pressure relief valves (PRVs) and flow control valves (FCVs) have been installed on the bioventing blower system. A manual FCV, or bleed valve, has been installed in the outlet piping leading to each VW, allowing the flow rate to each VW to be manually adjusted. An automatic FCV, or PRV, is used to protect the blower system from burning out if pressure rises due to pipe blockage. The PRV is set to bleed off air flow at a preset pressure, and thus will prevent blower outlet pressures from exceeding the rated pressure.

TABLE 2.1
INITIAL AND FINAL AIR FLOW RATES

BUILDING 8200
FORT CARSON, COLORADO

Rotary-Vane Blower

Monitoring Location	Initial Air Velocity (fpm) ^{a/}	Initial Flow Rate (acfm) ^{b/} ^{c/}	Final Air Velocity (fpm)	Final Flow Rate (acfm) ^{d/}
FCMW89/VW1	1,000	5.4	575	3.1
VW2	425	2.3	575	3.1
FCMW88/VW4	325	1.8	350	1.9
VW5	1,000	5.4	1,200	6.5
VW6	360	1.9	600	3.2
VW7-Shallow	1,000	5.4	975	5.3
VW7-Deep	950	5.1	1,200	6.5
Total Blower Output		27.3		29.6

Regenerative Blower

Monitoring Location	Initial Air Velocity (fpm)	Initial Flow Rate (acfm) ^{e/}	Final Air Velocity (fpm) ^{f/}	Final Flow Rate (acfm) ^{g/}
VW3	0	0.0	1,500	32.7
Total Blower Output		0.0		32.7

^{a/} fpm = feet per minute. Pipe diameter = 1 inch.

^{b/} acfm = actual cubic feet per minute.

^{c/} Rotary-vane blower performance on May 14, 1997: Pressure= 6.5 pounds per square inch (psi). Vacuum and temperature gauges not installed.

^{d/} Rotary-vane blower performance on June 4, 1997: Pressure= 5.6 psi; Vacuum= 10 "H₂O; Temperature = 176 degrees Fahrenheit.

^{e/} Power to the regenerative blower was not available.

^{f/} Pipe diameter = 2 inches.

^{g/} Regenerative blower performance on June 4, 1997: Pressure= 9.5 "H₂O; Vacuum= 10 "H₂O; Temperature = 106 degrees Fahrenheit.

An additional FCV (bleed valve) has been installed to control the total air flow out of the blower by releasing excess air flow to the atmosphere. All of the FCVs have been set by Parsons ES personnel to deliver a calculated amount of air to each VW, and should not be adjusted.

As discussed in Section 2.2.1, each manifold pipe leading to an individual VW has also been equipped with a flow measurement port. These ports consist of brass bushings installed in the outlet piping inside the blower shed. These bushings, which should be capped during system operation, allow the insertion of a thermal anemometer for the measurement of air velocity. These ports are used to measure the flow of air into each individual VW, and should not be adjusted or utilized by unauthorized personnel.

SECTION 3

SYSTEM MAINTENANCE

Although the rotary-vane blower system installed at Building 8200 is relatively maintenance free, periodic system maintenance is required to ensure proper operation and long life. Recommended maintenance procedures and schedule are described in detail in the manufacturers' instruction manuals included in Appendix B and briefly summarized in this section.

3.1 Blower/Motor

The blower and motor are relatively maintenance free and should not require any maintenance during the operational period. Both the blower and motor have sealed bearings and do not require lubrication.

3.2 Air Filter

To avoid damage caused by passing solids through the blower, a primary air filter has been installed in-line before the blower. The paper filter element is accompanied by a polyurethane foam prefilter. The filters should be checked weekly for the first 2 months of operation. Based on the first 2 months of system monitoring, a facility employee should be able to determine the best schedule for filter replacement. The polyurethane prefilters can be washed with lukewarm water and a mild detergent. Paper filter elements should never be washed, and should be disposed of and replaced as necessary. When the pressure or vacuum drop across the filter is 15 inches of water or greater, a dirty filter element should be suspected, and cleaning or replacement should be performed. Typical filter element replacement intervals range from 3 to 6 months.

To remove the filter:

1. Turn the system off by turning the breaker off,
2. Loosen the wing nut on the filter top,
3. Lift the metal top off the air filter; and
4. Lift the air filter element from the metal housing.

Remove the polyurethane prefilter (if applicable) and wash before replacing. If the paper element is not appreciably clogged, the prefilter may be washed and replaced around the paper element. The entire filter unit is then installed by reversing steps 2

through 4. The secondary air filter will not require any maintenance. After the filter has been washed and/or replaced, restart the blower by turning the breaker on. Do not adjust any of the FCVs during the filter changing procedure; they have been set by Parsons ES personnel to deliver a calculated volume of air to each individual VW. Altering FCV setting may unbalance the system and greatly reduce the effectiveness of the remedial technology.

The filter element is manufactured by Gast Manufacturing Corporation in Benton Harbor, Michigan. Their telephone number is (616) 926-6171. The part number for the replacement paper filter element is AJ134E. Spare air filter elements have been placed inside the blower enclosure.

3.3 Maintenance Schedule

The following maintenance schedule is recommended for the blower system. During the initial few months of operation, more frequent monitoring is recommended to ensure that any startup problems are quickly corrected. A daily drive-by inspection is recommended during the initial 2 weeks of operation to ensure that the blower system is operating normally. Thereafter, monitoring inspections every 2 weeks are recommended (see Section 4). Preprinted data collection sheets have been provided to facility personnel. Extra data collection sheets for recording maintenance activities are provided in Appendix C.

Maintenance Item	Maintenance Frequency
Filters	Check once every 2 weeks, wash prefilter and/or replace paper filter as necessary (see Section 3.2). Inlet vacuum exceeding 15 inches of water indicates that the filters require cleaning or replacement.

3.4 Major Repairs

Blower systems are very reliable when properly maintained. Occasionally, however, a motor or blower will develop a serious problem. If a blower system fails to start, and a qualified electrician verifies that power is available at the blower or starter, Parsons ES should be contacted to arrange for repairs. The Parsons ES contact is Mr. Dave Teets at (303) 831-8100. Parsons ES is responsible for major repairs during the first year of operation.

SECTION 4

SYSTEM MONITORING

4.1 Blower Performance Monitoring

To monitor the performance of the blower, the inlet vacuum, outlet temperature and outlet pressure should be measured at the blower. These data should be recorded every 2 weeks on a data collection sheet (provided in Appendix C). All measurements should be taken at the same time, while the system is running. Because the blower is noisy, hearing protection should be worn at all times.

4.1.1 Vacuum

With hearing protection in place, unlock and open the blower enclosure and record the vacuum directly from the gauge (in inches of water). Record the measurement on the data collection sheet.

4.1.2 Temperature

With hearing protection in place, unlock and open the blower enclosure and record the temperature directly from the gauge in degrees Fahrenheit (°F). Record the measurement on the data collection sheet (provided in Appendix C). The temperature change can be converted to degrees Celsius (°C) using the formula $^{\circ}\text{C} = (^{\circ}\text{F} - 32) \times 5/9$.

4.1.3 Pressure

With hearing protection in place, unlock and open the blower enclosure and record the main blower pressure (in psi) from the pressure gauge located on the blower outlet piping next to the temperature gauge.

4.2 Monitoring Schedule

During the initial month of operation, more frequent monitoring is recommended to ensure that any start up problems are quickly corrected. The following monitoring schedule is recommended for this system.

Monitoring Item	Monitoring Frequency
Vacuum/Pressure	Once every 2 weeks.
Temperature	Once every 2 weeks.

APPENDIX A
RECORD DRAWINGS

AU	APPROX	AIR INJECTION
ASTM		APPROXIMATE
		AMERICAN SOCIETY FOR
		TESTING AND MATERIALS
		AND
&		AT
BLDG		BUILDING
CBM		CENTER BACK MOUNT
DIA		DIAMETER
E		ELECTRICAL
eg		FOR EXAMPLE
FPT		FEMALE PIPE THREAD
FT		FOOT
G		GAS
GALV		GALVANIZED STEEL
HOPE		HIGH-DENSITY POLYETHYLENE
LA		LOWER MOUNT
MAX		MAXIMUM
MIN		MINIMUM
MON		MONITORING POINT
MP		MALE PIPE THREAD
#		NUMBER
NPT		NATIONAL PIPE THREAD
NTS		NOT TO SCALE
OD		OUTSIDE DIAMETER
QD		QUARTER
PVC		POLYVINYL CHLORIDE
PSI		POUNDS PER SQUARE INCH
REF		REFERENCE
SCH		SCHEDULE
S		SEWER
SPVC		SLOTTED POLYVINYL CHLORIDE
ST		STORM SEWER
ST STL		STAINLESS STEEL
TYP		TYPICAL
UE		UNDERGROUND ELECTRIC
UST		UNDERGROUND STORAGE TANK
VW		VENT WELL
W		WATER
W/		WITH
WWF		WELDED WIRE FABRIC

8200-MWI ☉
EXISTING GROUNDWATER MONITORING WELL

MFA ●
EXISTING BIOVENTING MONITORING POINT

VMT ▲
EXISTING VENT WELL

SB6 ●
PREVIOUS SOIL BORING

DP1 ○
PREVIOUS DIRECT PUSH SOIL/WATER SAMPLING LOCATION

MPH ⊕
NEW BIOVENTING MONITORING POINT












VM4 △
NEW VENT WELL

--- --
HEADER PIPE TO VENT WELL

* * * * *
FENCE

	GALV	GALVANIZED STEEL
PVC		POLYVINYL CHLORIDE
SPVC		SCREENED POLYVINYL CHLORIDE

AIJ AIR INJECTION

ASPHALT	BENTONITE	BENTONITE/CEMENT GROUT	BENTONITE PELLETS	BUILDING (EXISTING)	COMPACTED BACKFILL	COMPACTED BASE STONE	CONCRETE	PEA GRAVEL	SAND	UNDISTURBED SOIL
										

DRAWING OF ORIGIN

SCALE: NT


SCALE

SCALE: NTS


SCALE

DRAWING OF ORIGIN


SCALE: NTS

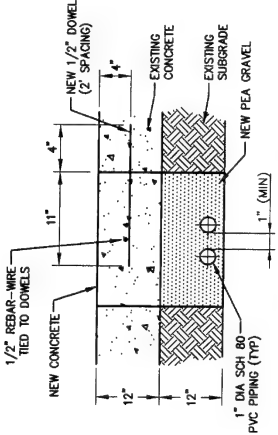


SCAF: NTS

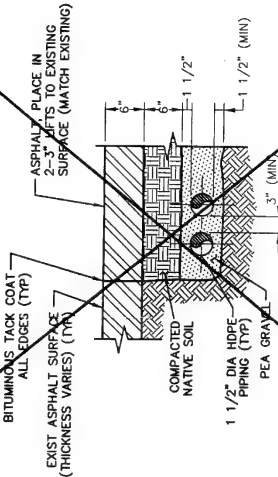

COPIES 1580

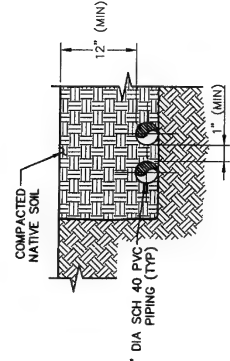

INFORM


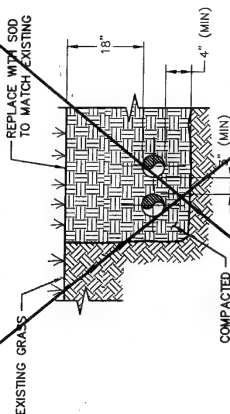



**AIR FORCE CENTER FOR
ENVIRONMENTAL EXCELLENCE
(AFCEE)
EXPANDED BIOVENTING SYSTEM
BUILDING 8200
FORT CARSON**

PARSONS ENGINEERING SCIENCE, INC.
Denver, Colorado
(303) 831-8100

LEGEND AND
STANDARD TRENCH DETAILS

Date	Rev	Date	Description	By
Job No. 726876.73340				
Drawn DBT				
Drawn MW				
CHECKED DBT		7/1/97		
Reviewed		7/1/97	Record Design	
Approved	1	6/5/97		

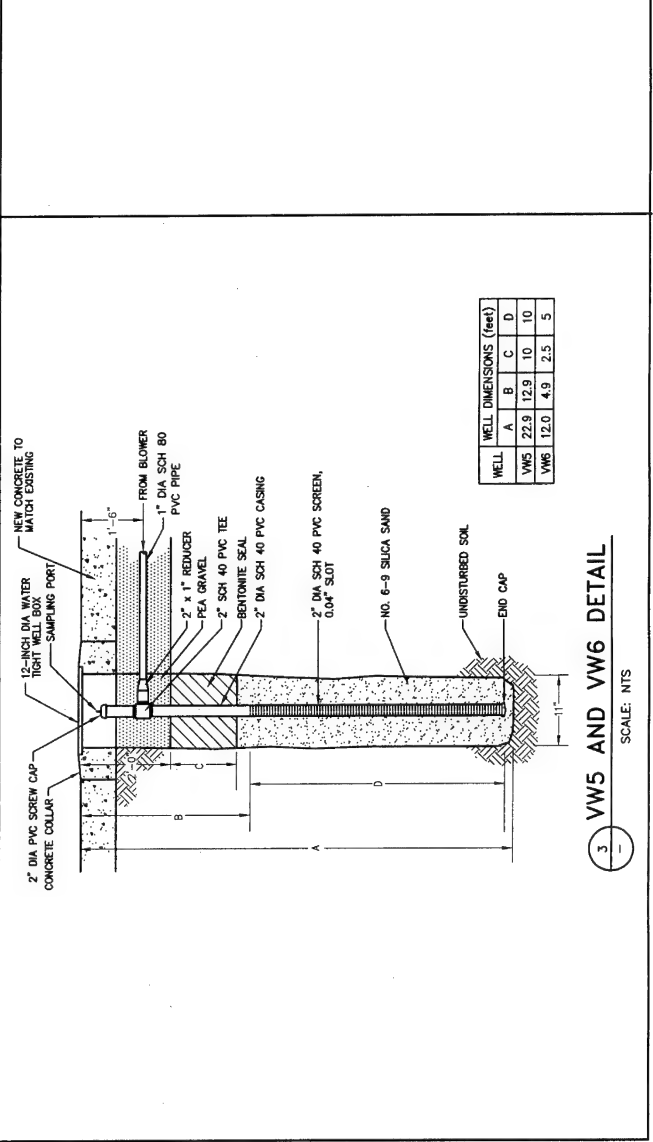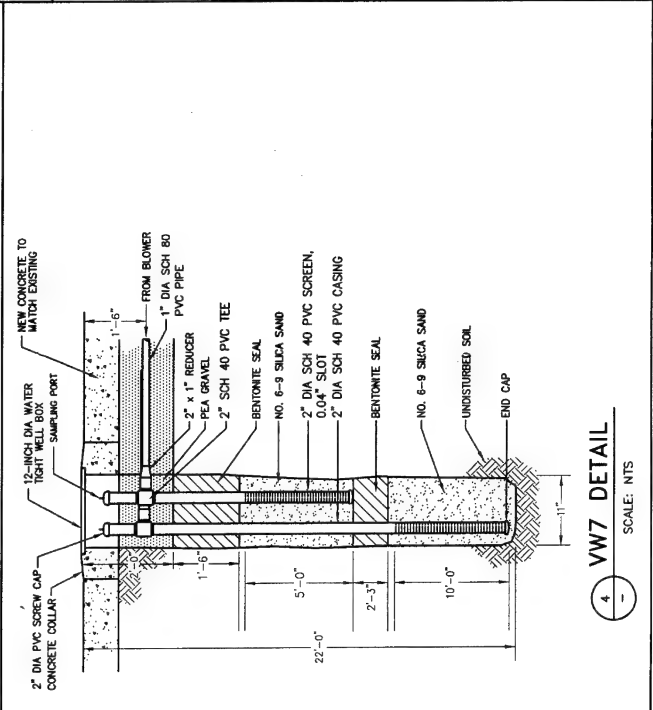


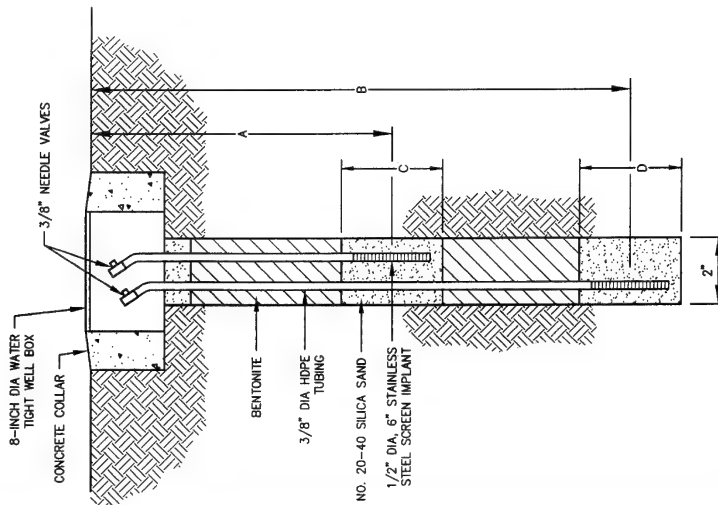

MONITORING POINT	DEPTH TO SCREEN INTERVALS (ft. bgs/a/)			SAND PACK THICKNESS (ft)
	A	B	C	
MPA	16.0	19.0	1.0	1.0
MPB	15.5	20.0	1.0	1.0
MPC	15.0	23.0	2.0	2.0
MPD	13.0	22.0	2.0	5.0
MPH	12.0	20.5	7.0	5.0

ft bgs = feet below ground surface


1 MONITORING POINT (MP) DETAIL
SCALE: NTS

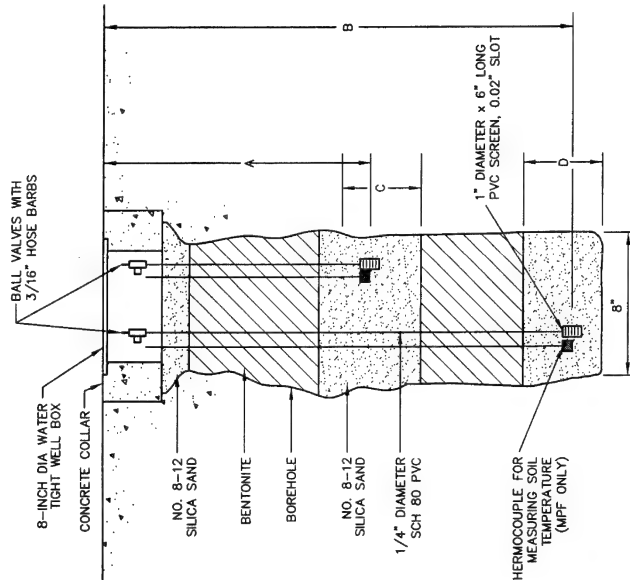

MONITORING POINT	DEPTH TO SCREEN INTERVALS (ft $\text{bg}/\text{a}/$)		SAND PACK THICKNESS (ft)		
	A	B	C	D	
MPD	10.0	18.0	4.0	4.5	
MPE	7.0	11.0	2.0	2.5	
MPE	12.0	16.0	2.0	2.0	

ft bgs = feet below ground surface

2 — MP DETAIL
SCALE: NTS

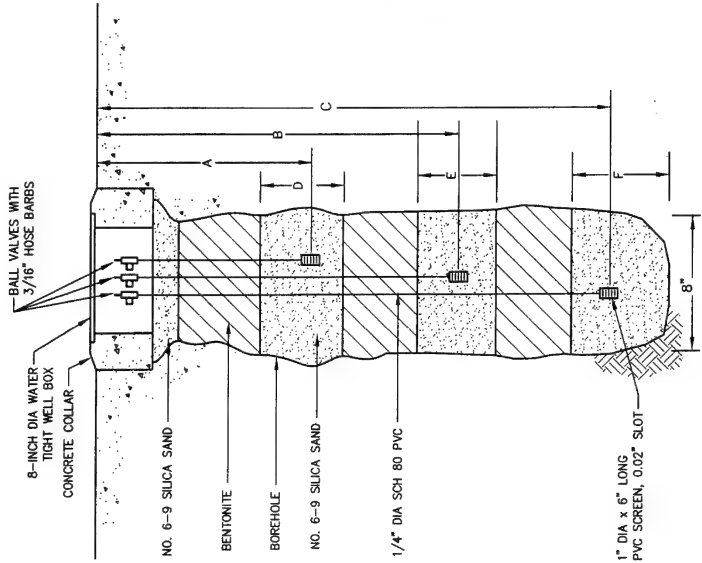


MONITORING POINT	DEPTH TO SCREEN INTERVALS (ft) (bgs)/			SAND PACK THICKNESS (ft)				
	A	B	C	D	E	F		
MP1	11.3	16.4	NA b/	4	5	NA		
MPJ	10.8	19.8	NA	5	7	NA		
MPK	4.8	NA	NA	2	NA	NA		
MPL	10.2	15.8	22.3	4	4	5		
MPW	5.5	10.2	NA	3	3	NA		

ft bgs = feet below ground surface
NA = Not Applicable

3 — MP DETAIL
SCALE: NTS

AIR FORCE CENTER FOR ENVIRONMENTAL EXCELLENCE (AFCEE) EXPANDED BROWNTING SYSTEM FORT CARSON DENVER, COLORADO		BLOWER P & ID ROTARY-VANE		DRAWING NO G-0.5	REV 1
PARSONS ENGINEERING SCIENCE, INC. (503) 831-8100 Denver, Colorado		Job No. 726876.7.2340 Designed DBT Drawn RSM Checked DBT Reviewed <i>[Signature]</i> Approved <i>[Signature]</i> Reg No. 6/30/97		Date Rev 1 6/30/97 Record Drawing By	

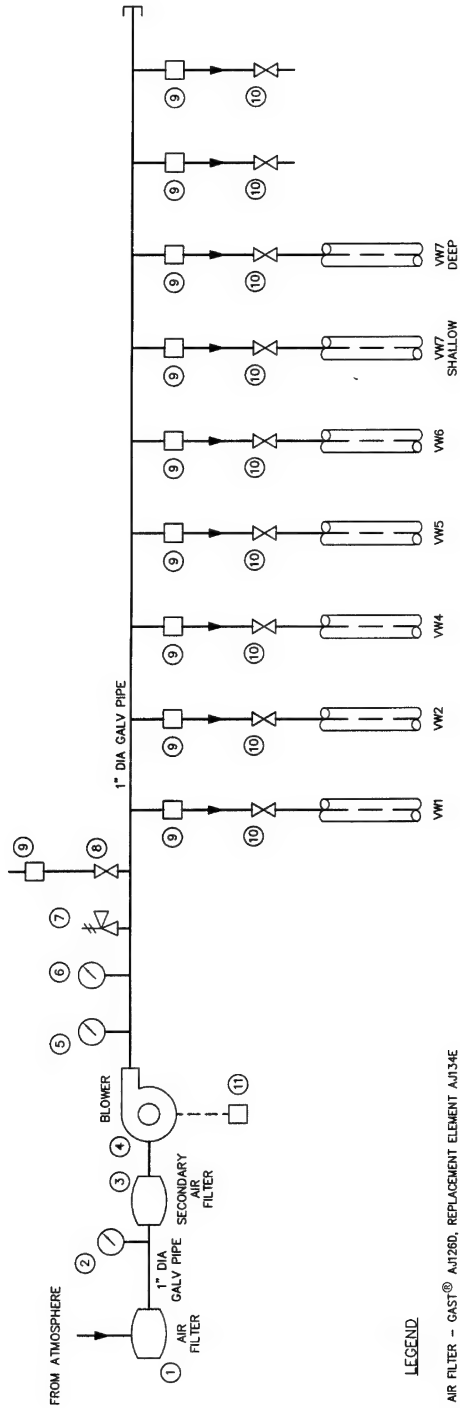


LEGEND

- 1 INLET AIR FILTER - GAST® AJ1260, REPLACEMENT ELEMENT AJ134E
- 2 VACUUM GAUGE, GAST® AJ497 2 3/4" DIA., 0-60" H₂O 1/4" NPT, LM
- 3 SECONDARY AIR FILTER - GAST® AD560, REPLACEMENT ELEMENT A0752
- 4 BLOWER - GAST® 5.0 HP 6066-P122-T339, 53 CFM AT 5 PSI
- 5 PRESSURE GAUGE - GAST® A4644B, 2" DIA., 0-30 PSI, 1/4" NPT, LM
- 6 TEMPERATURE GAUGE - ASHROFT, 0-250°F, 1/2" NPT, CBM (Part No. 2A606 FROM GRANGER)
- 7 AUTOMATIC PRESSURE RELIEF VALVE - GAST® AA307, ADJUSTABLE, 2-25 PSI PRESSURE
- 8 MANUAL PRESSURE RELIEF (BLEED) VALVE - 1" GATE
- 9 FLOW MEASURING PORT FITTED WITH PLUG (1/4"x 1/8" NPT BRASS REDUCING BUSHING, 1/8" NPT BRASS PLUG)
- 10 FLOW CONTROL VALVE - 1" GATE
- 11 STARTER AND FUSED DISCONNECT SWITCH

1 ROTARY-VANE BLOWER PIPING AND INSTRUMENTATION DIAGRAM

SCALE: NTS

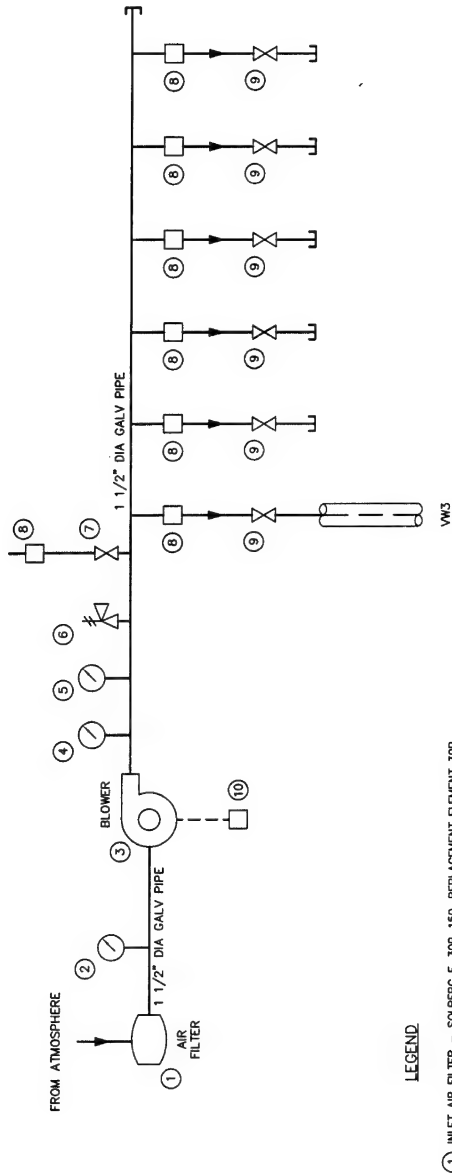

LEGEND

- ① INLET AIR FILTER - SOUBERG F-30P-150, REPLACEMENT ELEMENT 30P
- ② VACUUM GAUGE - GAST® AL497, 2 1/2" DIA, 0-80" H₂O, 1/4" NPT, LM
- ③ BLOWER - GAST® 2.0HP R5125Q-50, 140 CFM AT 20" H₂O PRESSURE
- ④ TEMPERATURE GAUGE - ASHCROFT, 0-250°F, 1/2" NPT, CBM (Part No. 2A606 FROM GRANGER)
- ⑤ PRESSURE GAUGE - WKA 611.10, 2 1/2" DIA., 0-100" H₂O, 1/4" NPT, LM (Part No. 9851810)
- ⑥ AUTOMATIC PRESSURE RELIEF VALVE - GAST® AG258, SET TO RELEASE AT 45" H₂O PRESSURE
- ⑦ MANUAL PRESSURE RELIEF (BLEED) VALVE - 1 1/2" GATE
- ⑧ FLOW MEASURING PORT FITTED WITH PLUG (1/4" x 1/8" NPT BRASS REDUCING BUSHING, 1/8" NPT BRASS PLUG)
- ⑨ FLOW CONTROL VALVE - 1 1/2" GATE
- ⑩ STARTER


REGENERATIVE BLOWER PIPING AND INSTRUMENTATION DIAGRAM

SCALE: NTS




By Description Record Drawing 7/11/97 6/30/97 31192	Rev Date 1 6/30/97 31192	Job No. 726876.73340 Design RSM Checked DBT Approved DBT 7/11/97	Parsons ENGINEERING SCIENCE, INC. Denver, Colorado (303) 831-8100	AIR FORCE CENTER FOR ENVIRONMENTAL EXCELLENCE (AFCEE) EXPANDED BLOWING SYSTEM BUILDING 8200 FORT CARSON	ROTARY-VANE BLOWER PIPING LAYOUT DETAIL	DRAWING NO G-0.6 REV 1
--	--------------------------------------	--	--	--	---	---------------------------------

- NOTES:
1. ALL PIPING 1" DIA. GALVANIZED STEEL, UNLESS OTHERWISE NOTED
 2. SEE DRAWING G-0.7 FOR BLOWER BUILDING DETAILS

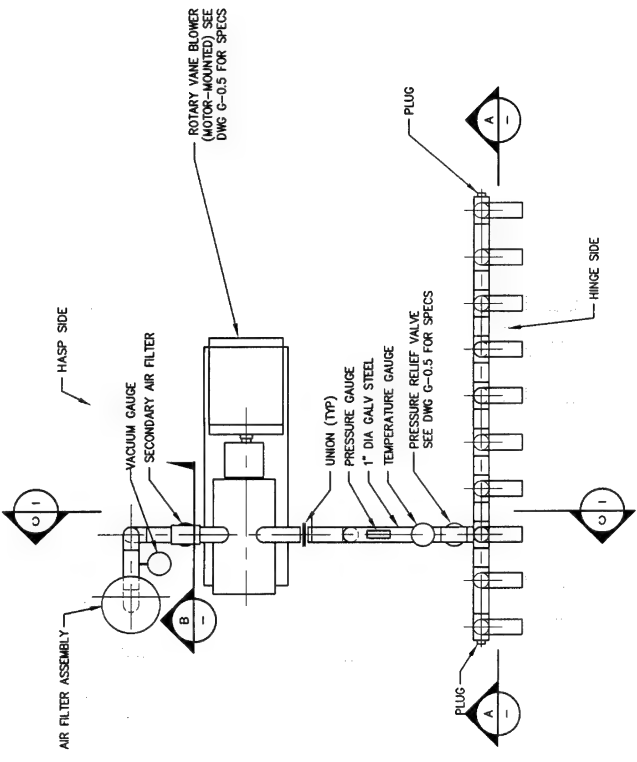


1 BLOWER PIPING LAYOUT PLAN DETAIL

3/4" = 1'-0"

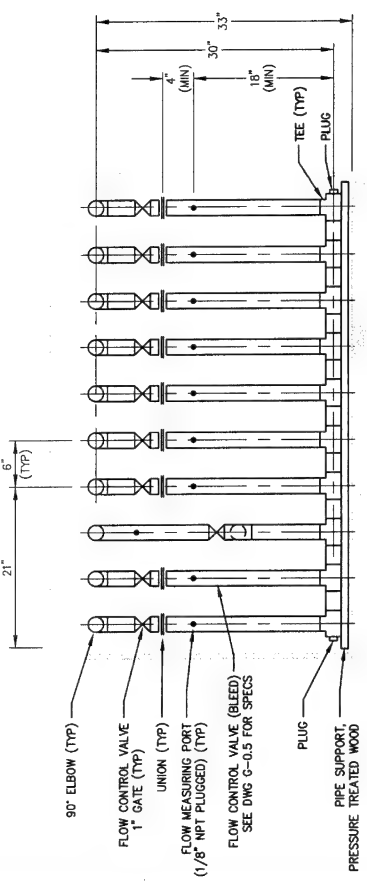


A MANIFOLD DETAIL SECTION

3/4" = 1'-0"

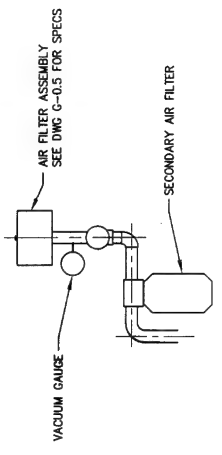


B BLOWER INLET PIPING SECTION

3/4" = 1'-0"

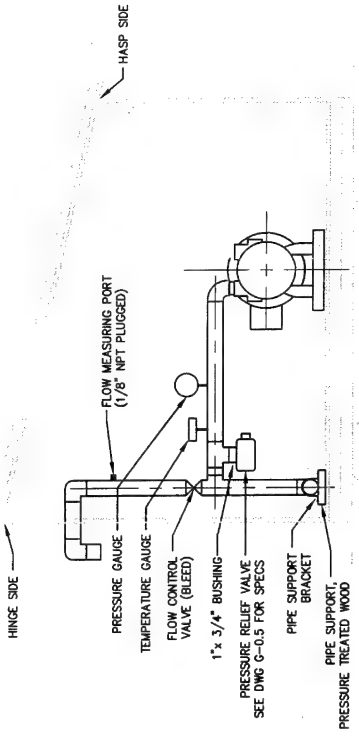

C BLOWER OUTLET PIPING SECTION

3/4" = 1'-0"

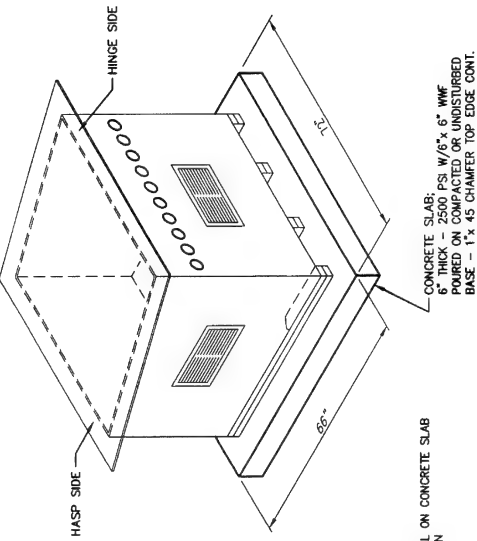


NOTES:
1. BUILDING INSTALLED CENTRAL ON CONCRETE SLAB
WITH ORIENTATION AS SHOWN

CONCRETE SLAB:
6" THICK - 2500 PSI W/6"x 6" WWF
POURED ON COMPACTED OR UNDISTURBED
BASE - 1"x 45 CHAMFER TOP EDGE CONT.


BLOWER SHED FIELD INSTALLATION DETAIL

NOT TO SCALE

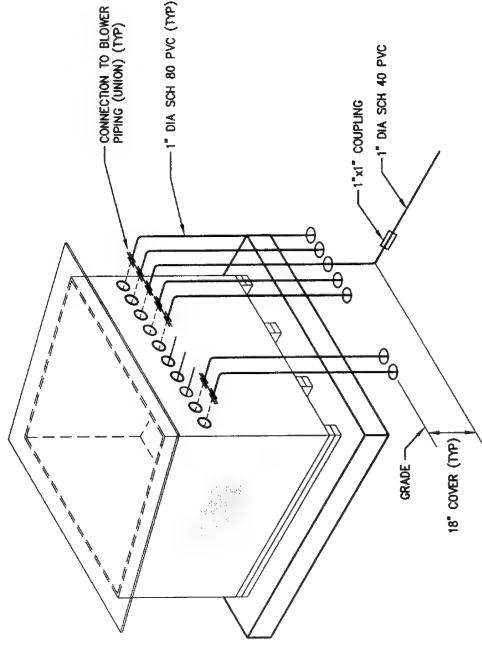


TYPICAL MANIFOLD DISCHARGE PIPING LAYOUT

NOT TO SCALE

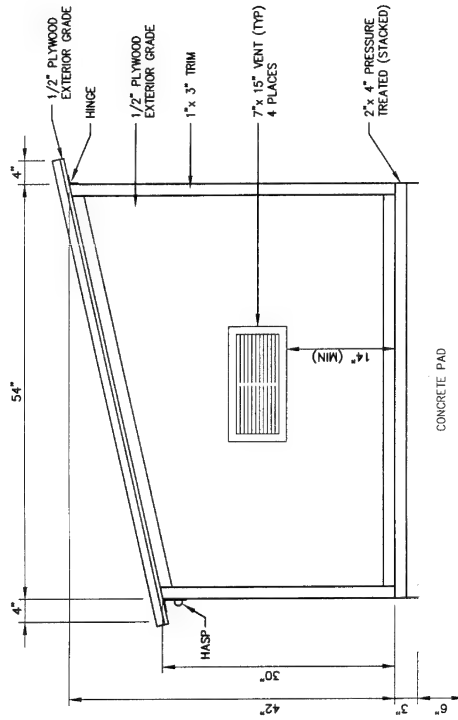

SIDE ELEVATION

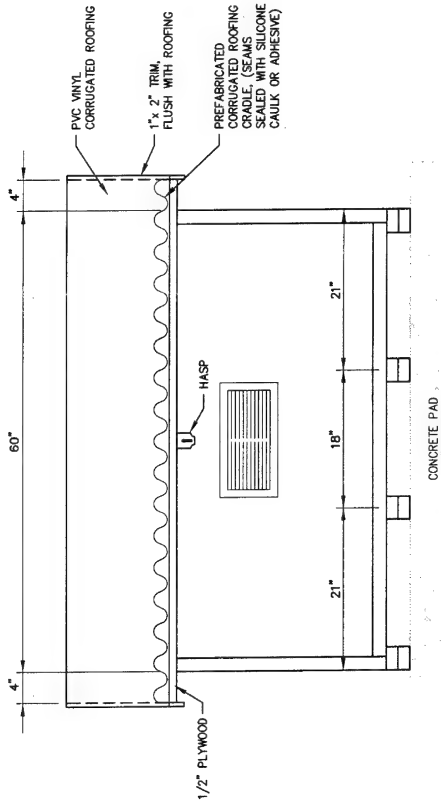

FRONT ELEVATION


- NOTES:
1. 2" x 2" FRAME CONSTRUCTION
 2. FLOOR CONSTRUCTED OF 3/4" EXTERIOR GRADE PLYWOOD
 3. ROOF CONSTRUCTED OF 1/2" EXTERIOR GRADE PLYWOOD COVERED WITH PVC VINYL CORRUGATED ROOFING

BLOWER SHED CONSTRUCTION DETAIL

3/4" = 1'-0"

<p>Job No. 726876.7340 Designed DBT Drawn RSM Checked PMS Approved JH Rev No. 1 Rev Date 8/30/97 Record Drawing</p>	<p>PARSONS ENGINEERING SCIENCE, INC. Denver, Colorado (303) 831-8100</p>	<p>AIR FORCE CENTER FOR ENVIRONMENTAL EXCELLENCE (AFCEE) EXPANDED BLOWING SYSTEM BUILDING 8200 FORT CARSON</p>	<p>CONSTRUCTION DETAILS AND BLOWER SHED INSTALLATION DETAIL</p>	<p>DRAWING NO. G-0.7 REV. 1</p>
---	--	--	---	-------------------------------------

APPENDIX B
ROTARY-VANE BLOWER INFORMATION

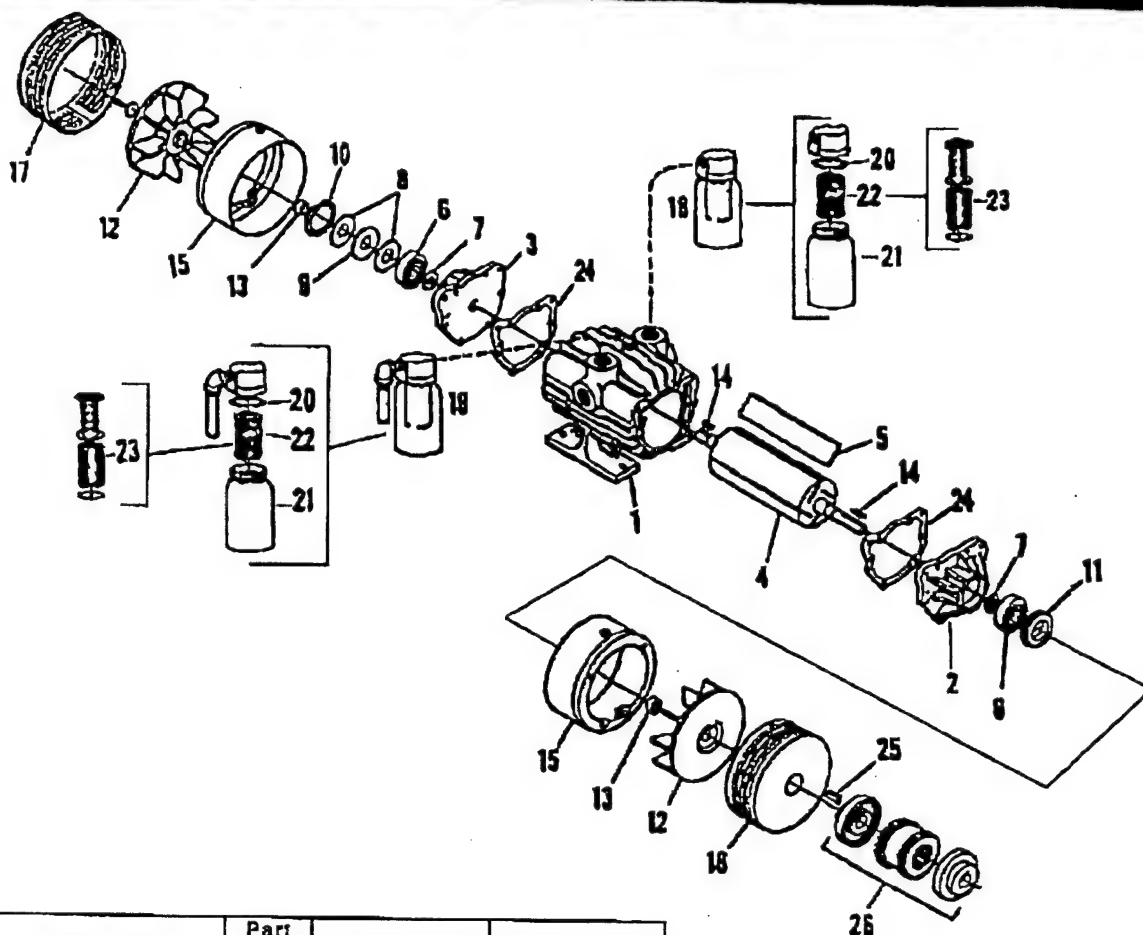6066 PARTS ORDERING INFORMATION

Ref. No.	Description	Part Qty	6066-P102	6066-V103
1	Body	1	AC309	AC309
2	End Plate, Drive	1	AE293	AE293
3	End Plate, Dead	1	AE294	AE294
4	Rotor Assembly	1	AE295A	AE295A
5	Vane	4	AK738	AK738
6	Bearing	2	AB964B	AB964B
7	Bearing Shoulder Ring	2	AB926T	AB926T
8	Belleville Spring	2	AB791	AB791
9	Shim Washer	1	AB792	AB792
10	Retaining Ring	1	AB793	AB793
11	End Cap	1	AB790	AB790
12	Fan	2	AK735	AK735
13	Fan Spacer	2	AE299	AE299
14	Square Key	2	AB136A	AB136A
15	Shroud	2	AE300A	AE300A
16	Fan Guard Asmb., Drive	1	AK736	AK736
17	Fan Guard Asmb., Dead	1	AK737	AK737
18	Intake Filter Assembly	1	AD560	AD560
19	Muffler Assembly	1		AD560B
20	Cover Gasket	1	AD562	
		2		AD562
21	Jar	1	AD563A	
		2		AD563A
22	Filter Element Assembly	1	AD750	
		2		AD750
23	Filter Felt	1	AD752	
		2		AD752
24	Body Spacer	1	AE315B	AE315B
		2		
25	Key, Coupling	1	AB136D	AB136D
26	Coupling Assembly	1	AE765	AE765
27	Check Valve (not shown)	1	AH326B	AH326B
	Service Kit	1	K603	K503

♦ Denotes parts included in the service kit.

Parts listed are for stock models. For specific OEM models, consult the factory.
When corresponding or ordering parts, please give model and serial numbers.

This is the hazard alert symbol: **⚠** When you see this symbol, be aware that personal injury or property damage is possible. The hazard is explained in the text following the symbol. Read the information carefully before proceeding.

The following is an explanation of the three different types of hazards:

- ⚠ DANGER** Severe personal injury or death will occur if hazard is ignored.
- ⚠ WARNING** Severe personal injury or death can occur if hazard is ignored.
- ⚠ CAUTION** Minor injury or property damage can occur if hazard is ignored.

GENERAL INFORMATION

This pump is only to be used for the purpose of pumping air and under no circumstances be used with any other gases. The pump must not be used for the pumping of fluids, particles, solids or any substance mixed with air, particularly combustible substances likely to cause explosions.

- ⚠ DANGER** Do not pump flammable or explosive gases or operate the unit in an atmosphere containing them.
- ⚠ CAUTION** The exhaust air of this pump can become very hot. Do not direct exhaust air towards property that is temperature sensitive.
- ⚠ CAUTION** The pump is designed for air only. Do not allow corrosive gases or particulate material to enter the pump. Water vapor, oil-based contaminants, or other liquids must be filtered out.

Ambient temperature should not exceed 40°C (104°F). For operation at high temperatures, consult the factory.

Performance is reduced by low atmospheric pressure found at high altitudes. Consult a Gast distributor for details.

Never lubricate this oil-less rotary vane pump. The sealed bearings are grease-packed. The service life of the carbon vanes will be reduced by petroleum or hydrocarbon products.

INSTALLATION

- ⚠ CAUTION** Do not lift the unit by the fan shrouds. The unit should be lifted by means of the eye bolt.
- ⚠ WARNING** To avoid risk of electrocution do not use this product in an area where it could come in contact with water or other liquids.

If exposed to the elements it must be weather protected.

- ⚠ CAUTION** Do not block the flow of cooling air over the pump in any way.
- ⚠ WARNING** Some models are equipped with glass jars. Proper measures should be taken to guard against the fragmenting or breaking of glass if an alternative material is not used. If hazard is ignored severe personal injury or death can occur.

MOUNTING THE PUMP

The pump may be installed in any orientation as long as the flow of cool, ambient air over the pump is not blocked. To reduce noise and vibration, mount to a stable, rigid operating surface.

PLUMBING

To prevent air flow restriction, use pipe and fittings that are the same size or larger than the threaded ports of the pump. The ports are marked "IN" and "OUT".

ACCESSORIES

Intake and exhaust filters are external to the pump and will provide adequate filtration for most applications. Check filters periodically and replace when necessary. Consult a Gast Representative for additional filter recommendations. Install relief valves and gauges at the inlet or outlet, or both, to monitor performance. Check valves may be required to prevent backstreaming through the pump.

WIRING

- ⚠ WARNING** Incorrect wiring can result in electric shock. Wiring must conform to all required safety codes and be installed by a qualified person. Grounding is required. All power to the motor must be de-energized and disconnected when servicing.

ELECTRIC MOTOR CONTROL

The motor must be protected against short circuit, overload and excessive temperature rise. Fuses, motor protective switches and thermal protective switches provide the necessary protection in these circumstances. Fuses only serve as a short circuit protection of the motor (wiring fault). Fuses in the incoming line should be chosen so as to be able to withstand the starting current of the motor, not as a protection against overload. Motor starters, incorporating thermal magnetic overload or circuit breakers protect the motor from overload or reduced voltage conditions. Selection of the correct overload setting is required to provide the best possible protection. Refer to the motor starter manufacturer's recommendations.

ELECTRIC MOTOR CONNECTION

Refer to the motor nameplate for wiring diagram. If the motor fails to start or slows down under load, shut the pump off and unplug. Check that the supply voltage agrees with the motor nameplate. Be sure the three phase motor turns in the proper direction of rotation after installation. Turning in the wrong direction will drastically reduce vane life.

OPERATION

⚠ WARNING Solid or liquid material exiting the unit can cause eye or skin damage. Keep away from air stream.

⚠ WARNING Always disconnect the power before servicing. The motor may be thermally protected and will restart automatically when it cools if the thermal protection switch is tripped.

⚠ WARNING Do not operate without both the coupling guard and shroud in place. Failure to do so could result in severe personal injury.

⚠ CAUTION Do not operate units above recommended pressures or vacuum duties. To do so will damage the unit.

⚠ WARNING Beware of any exposed and/or movable part. Proper guards should be in place to prevent personal and/or property damage.

STARTING

If the pump is extremely cold, let it warm up to room temperature before starting. If the pump does not operate properly, see the troubleshooting guide.

⚠ WARNING Some of these models may exceed 85 dB(A). When in close proximity to these models hearing protection is required. See Technical Data Sheet (if provided), for specific model(s).

MAINTENANCE AND INSPECTION

Regular inspection can prevent unnecessary damage and repairs. The intake and exhaust filters require periodic inspection and replacement. Initial inspection is suggested at 500 hours, then the user should determine the frequency. Most problems can be prevented by keeping filters clean. Dirty filters decrease pump performance and can decrease pump service life.

FILTER INSPECTION AND REPLACEMENT

⚠ WARNING The pump surfaces may become very hot during operation. Do not touch these parts until the pump has been turned off and allowed to cool.

Refer to the proper exploded view during the following procedure.

With the pump turned off and isolated from power supply, and all pressure and vacuum is released from the pump, remove the felts from the intake and exhaust filters and wash them in a solvent. When clean and dry, replace them.

FLUSHING

Flushing of the pump is accomplished by removing the filter assemblies and while the pump is running, add several tablespoons or spray solvent directly into the intake port. Recommended is Gast flushing solvent part number AH255B.

⚠ WARNING Do not use kerosene, gasoline or any flammable liquid.

⚠ WARNING Flush unit in a well ventilated area. Eye protection is recommended. Keep face away from exhaust port.

After solvent has passed through the pump, replace the filter assemblies.

Before putting the pump back into service, ensure that any external accessories such as relief valves and gauges have not been damaged.

SHUTDOWN PROCEDURES

Proper shutdown procedures must be followed to prevent pump damage. Failure to do so may result in premature pump failure. The Gast Manufacturing rotary vane non-lubricated vacuum pumps and compressors are constructed of ferrous metals or aluminum which are subject to rust and corrosion when pumping condensable vapors such as water.

Follow the steps below to assure correct storage and shutdown between use:

1. NEVER oil this non-lubricated pump.
2. After using the pump, disconnect plumbing and allow the pump to run "open" for at least 5 minutes before shutdown.
3. Be sure to plug open ports so dirt and other contaminants do not enter the unit. It is now ready for shutdown or storage.

SERVICE KIT INSTALLATION

NOTE: Gast will not guarantee the performance of a field rebuilt pump. You can return the pump to a Gast authorized service facility, or perform the rebuild procedures described below.

Each service kit contains most or all of the following: bearings, vanes, gaskets, and filter elements.

SERVICE KIT INSTALLATION

Follow these general steps to install the kit:

PUMP DISASSEMBLY:

1. Disconnect the pump from the electrical power.

⚠ WARNING You must disconnect the pump from electrical power before servicing it. Failure to do so can result in severe personal injury or death.

2. Vent all air lines to the pump to remove pressure.

⚠ WARNING You must vent all air lines to the pump to remove pressure before servicing it. Failure to do so can result in severe personal injury.

3. Remove the dead end shroud, fan & fan spacer.
4. Use a wheel puller to remove the dead-end plate and bearing from the pump body; note the direction of the bevel edge on the vane. Do not damage the dowel pins between the end plate and the body. Save the bearing spacer on the dead-end of the shaft for reassembly. Remove the snap ring from the end plate. Save the snap ring, belleville springs, and washer for reassembly.
5. Remove the bearing from the dead-end plate.
6. Check the exposed surfaces of the rotor, body, and end plate for scoring. If you find no scoring, you can perform a Minor Rebuild to replace only the vanes and the dead-end bearing. If you find severe damage, perform the Major Rebuild:

MINOR REBUILD:

7. Install the new vanes supplied with the kit. Be careful to face the vane bevels in the proper direction (as noted in step 4).
8. Place end plate over the shaft with dowel pins aligned. Place bearing spacer on dead end of shaft. Place the new bearing in its bore in the dead end plate. Be careful to press only on the inner bearing race.
9. Install and tighten the pump body bolts. Install the belleville springs with the washer between them, and the snap ring.

MAJOR REBUILD:

7. Remove the drive end cap. Use a wheel puller to remove the drive end plate and bearing from the body. Do not remove or damage the dowel pins in the body. Save the bearing spacer and endplate gasket for reassembly.
8. Place one of the new bearings in its seat in the drive-end plate, then place one of the shoulder rings on the drive-end of the shaft. Using an arbor press, press the bearing onto the shaft. Be careful to press only on the inner bearing race. Tighten the pump body bolts.
9. Install the new vanes supplied with the kit. Be careful to face the vane bevels in the proper direction (as noted in step 4).
10. Perform step #8 from Minor Rebuild.
11. Install the belleville springs with the washer between them, and the snap ring. Install and tighten the pump body bolts.
12. Apply a thread-lock adhesive and start the drive end cap into its thread in the drive end plate, but do not tighten it.
13. Place a dial indicator against the dead-end of the shaft to measure axial movement. Tighten the drive end cap until the indicator show .002" to .003" of the shaft movement against the belleville springs.
14. Replace the filter elements.

TROUBLE SHOOTING GUIDE

Reason for Problem	Low Vacuum	Low Pressure	High Vacuum	High Pressure	Pump Overheating	Motor Overload
Filter dirty	X	X	at pump		X	X
Muffler dirty		X		at pump	X	X
Vacuum line collapsed	X		at pump		X	X
Relief valve set too high			X	X	X	X
Relief valves set too low	X	X				
Plugged vacuum/pressure line	X	X	at pump	at pump	X	X
Vanes sticking	X	X				
Running at too high RPM			X	X	X	X
Vanes worn (replace)	X	X				
Shaft seal worn (replace)	X	X				
Dust or offset powder in pump	X	X			X	X
Motor not wired correctly	X	X			X	

APPENDIX C
DATA COLLECTION SHEETS

[illegible]

[illegible]

